

REVISIONS		
No.	Revision Description	Date
2	COORDINATION	02/27/24
3	Bldg. Dept. Com.	04/05/24
4	COORDINATION	04/26/24
5	Bldg. Dept. Com.	04/26/24
6	COORDINATION	05/14/24
7	Bldg. Dept. Com.	06/18/24
8	COORDINATION	06/25/24
11	Bldg. Dept. Com.	08/13/24
14	COORDINATION	11/22/24
15	ADA/FHA Revision	01/07/25
17	COORDINATION	04/21/25

UNIT PLAN- WALL & SYMBOL LEGEND

	REINF. CMU WALL (REFER TO STRUCT.)	(2)	DENOTES QUANTITY
	REINF. CMU WALL (2 HOUR RATED) (REFER TO STRUCT.)	(R0)	DOOR NUMBER. REFER TO DOOR SCHEDULE
	REINF. SHEAR WALL (2 HR RATED)	CL	CENTER LINE
	8' LOW PARAPET WALL @ 42" MIN.	WS	WALL TYPE. SEE SHEET A-8.01
	TYP. METAL STUD PARTITION WALL	J	JUNCTION BOX (ELECT.) RECESS IN SLAB ABOVE / SCONCE ON WALL
	TYP. 1 HOUR TENANT SEPARATION/SMOKE BARRIER METAL STUD PARTITION WALL - REFER TO OVERALL FLOOR PLAN FOR WALL TYPE	EP	ELECTRICAL PANEL (COORDINATE WITH ELECTRICAL DRAWINGS)
	2 HOUR UL RATED SHAFT WALL	WS1	WINDOW SYSTEM. REFER TO WINDOW SCHEDULE
	WINDOW TYPE. REFER TO WINDOW SCHEDULE		WALL REINFORCEMENT REQUIRED FOR FUTURE GRAB BAR INSTALLATION AT ALL GF. UNITS (FHA COMPLIANT)

UNIT NOTES

- UNLESS OTHERWISE INDICATED, INTERIOR PARTITIONS, SHOULD BE WALL TYPE #29 & #31. REFER TO WALL TYPE SCHEDULE SHEET A-8.01.
- ALL WID CLOSET REAR WALLS SHALL BE W29 6" METAL STUD MIN.
- TYPICAL DIMENSIONS ARE TO FINISHED SURFACES. DIMENSIONS TO STRUCTURAL ELEMENTS ARE TO FACE OF CORE. THICKNESS OF BATHROOM TILE FINISHES ARE NOT INCLUDED IN WALL ASSEMBLY AND THEREFORE NOT INCLUDED IN FINISHED DIMENSIONS. REFER TO OVERALL FLOOR PLAN FOR OVERALL DIMENSION OF UNITS. OVERALL DIMENSION OF UNITS MAY VARY, BUT NO MORE THAN 6". DISCREPANCIES SHALL BE NOTIFIED TO ARCHITECT.
- FLOOR SHALL MEET AN IC OF 50 AND STC OF 50.
- DEMISING WALLS SHALL MEET A STC OF 50.
- FOR WINDOW TYPE AND LOCATION PLEASE REFER TO OVERALL FLOOR PLANS.
- ALL DOORS INTO ROOMS AND CLOSETS SHALL HAVE A CLEAR PASSAGE WIDTH OF 32" MIN.
- INSTALLATION OF HIGH SPEED INTERNET SHALL BE PROVIDED.
- NOTE: SEE SHEET A-8.03 FOR BATHROOM FIXTURE LEGEND
- FOR UNIT TYPE LIGHTING AND VENTILATION CALCULATIONS, SEE SHEET A-6.00 - A-6.11.
- PROVIDE LATITECRE HYDRO BAN LOAD BEARING WATERPROOFING MEMBRANE (OR APPROVED EQUAL) UNDER FLOORING/TILES AT ALL SHOWER WALLS AND THROUGHOUT THE ENTIRE BATHROOM FLOOR AREA.
- REFER TO A-8.08 FOR UNIT DOOR SCHEDULE, FINISH SCHEDULE AND FIXTURES SCHEDULE

CEILING NOTES

- COORDINATE ALL CEILING FIXTURES SHOWN ON REFLECTED CEILING PLAN WITH ELECTRICAL DRAWINGS. ALL FIXTURES IN FIRST FLOOR SLAB SHALL BE ONE HOUR FIRE RATED OR HAVE A FIRE RATED JUNCTION BOX INSTALLED TO MAINTAIN 1 HOUR SLAB RATING. ALL DISCREPANCIES SHALL BE BROUGHT TO THE ARCHITECT'S ATTENTION BEFORE PROCEEDING WITH THE WORK.
- ALL ELEVATIONS SHOWN ON PLAN TO BE ABOVE FINISH FLOOR SLAB (TYP. U.I.O.M.).
- FOR FIXTURE TYPE AND SPECIFICATIONS, SEE ELECTRICAL DRAWINGS. SUBMIT ALL SHOP DRAWINGS FOR APPROVAL PRIOR TO PROCUREMENT.
- FIXTURES SHALL NOT BE SPACED LESS THAN 4'-0" FROM OTHERS FIXTURES & SHALL BE EQUALLY SPACED WITHIN A ROOM OR SPACE, UNLESS OTHERWISE SHOWN - COORDINATE WITH FIRE ALARM DRAWINGS.
- COORDINATE WITH MECHANICAL AND FIRE PROTECTION DRAWINGS FOR LOCATION OF DUCT, DIFFUSER & SPRINKLER.
- ALL FIXTURES SHALL BE NEW & INSTALLED AS PER MANUFACTURER'S RECOMMENDATION.
- MINIMUM OF 7'-10" SHALL BE THE TYP. CEILING HEIGHT UNLESS OTHERWISE NOTED.
- ALL AUDIOVISUAL EMERGENCY EQUIPMENT SHALL BE AS PER OWNERS REQUIREMENTS AND GUIDELINES. CONTRACTOR SHALL REFER TO ELECTRICAL DRAWINGS AND CONSULT OWNER DURING AND AFTER BID PROCESS.
- VERIFY ALL SOFFIT SIZE AS REQ'D FOR RUNNING DUCTS.
- ALLOWANCE FOR ADDITIONAL SOFFITS SHALL BE PROVIDED FOR FIELD CONTINGENCY CONDITIONS.

CEILING LEGEND

	GYPSUM BOARD	J	JUNCTION BOX		SURFACE MOUNT LIGHT FIXTURE
	CEILING FAN - B.O. FAN SHALL BE 7" MIN. CLR. A.F.F.		8" RECESSED H-HAT LIGHT FIXTURE		WALL MOUNTED LIGHT FIXTURE


NOTES:

WINDOW TREATMENT: PROVIDE WINDOW TREATMENT BY HUNTER DOUGLAS OR APPROVED EQUAL. WINDOW TREATMENTS SHALL COMPLY WITH WDMA A 100.1 AND NFPA 701. PRODUCT SHALL BE MANUFACTURED FREE OF TOXIC OR HAZARDOUS MATERIALS. OPERABLE PARTS SHALL COMPLY WITH ADA REQUIREMENTS AND BE INSTALLED AT 48" MAX. AFF.

DIMENSIONS:
A. DIMENSIONS ARE TO FINISH SURFACES UNLESS OTHERWISE NOTED.
B. THICKNESS OF TILE NOT INCLUDED IN WALL ASSEMBLY AND THEREFORE NOT INCLUDED IN FINISHED DIMENSIONS.

UNIT KEYNOTE LEGEND


- | | |
|---|---|
| U1 ENERGY STAR REFRIGERATOR (PROVIDE CONNECTION FOR ICE MAKER) | U28 MIRROR TO MATCH WIDTH OF VANITY. HEIGHT TO BE COORDINATED WITH LIGHT FIXTURE. REFER TO A6.13, #7, FHA/ADA BATHROOM FIXTURE LEGEND. |
| U2 24" WIDE DISHWASHER (ENERGY STAR) ADA COMPLIANT @ ACCESSIBLE UNITS. | U29 TOILET PAPER HOLDER. REFER TO A6.13, #8, FHA/ADA BATHROOM FIXTURE LEGEND. |
| U3 FULL SIZE RANGE WITH OVEN AND MICROWAVE ABOVE/ FULLY ACC. RANGE WITH HOOD FAN ABOVE AT FULLY ACCESSIBLE UNITS. | U30 CURTAIN ROD. REFER TO FHA BATHROOM FIXTURE LEGEND A6.13 DTL #13. |
| U4 COUNTER TOP MICROWAVE ONLY @ ACCESSIBLE UNITS. | U31 TOWEL BAR. REFER TO FHA/ADA BATHROOM FIXTURE LEGEND A6.13 DTL #9. |
| U5 ENERGY STAR ELECTRIC WATER HEATER / A/H.U. PROVIDE MIN. 4" CLEARANCE AROUND A/H.U. PER FBC 2020 (MECH). | U32 HIDDEN LINE DENOTES FUTURE GRAB BAR INSTALLATION AT TOILET. WALL REINFORCEMENT IS REQUIRED. REFER TO FHA BATHROOM FIXTURE LEGEND A6.13 DTL #2, #5. |
| U6 FULL SIZE STACKABLE WASHER/DRYER (ENERGY STAR QUALIFIED) TYP. CONNECTIONS AS PER ELECTRICAL & PLUMBING. | U33 HIDDEN LINE DENOTES FUTURE GRAB BAR INSTALLATION AT TUB. WALL REINFORCEMENT IS REQUIRED. REFER TO FHA BATHROOM FIXTURE LEGEND A6.13 DTL #3A, #3B, 3C. |
| U7 FULL SIZE FRONT LOADING WASHER (ENERGY STAR) CONNECTIONS AS PER ELECTRICAL & PLUMBING. | U34 HIDDEN LINE DENOTES FUTURE GRAB BAR INSTALLATION AT SHOWER. WALL REINFORCEMENT IS REQUIRED. REFER TO FHA BATHROOM FIXTURE LEGEND A6.13, DTL #12, #12A. |
| U8 FULL SIZE FRONT LOADING DRYER (ENERGY STAR) CONNECTIONS AS PER ELECTRICAL & PLUMBING. | U35 GRAB BAR IN PLACE FOR ALL FULLY ACCESSIBLE UNITS AT TOILET. WALL REINFORCEMENT IS REQUIRED. REFER TO A6.13, #2, #3, ADA BATHROOM FIXTURE LEGEND. |
| U9 UNDER MOUNTED DOUBLE KITCHEN SINK W/ GARBAGE DISPOSAL, 0" DEEP MIN. 5" DEEP MAX @ FULLY ACCESSIBLE UNITS). | U36 GRAB BAR IN PLACE FOR ALL FULLY ACCESSIBLE UNITS AT ROLL-IN SHOWERS CLUBS SHOWER. WALL REINFORCEMENT IS REQUIRED. REFER TO A6.13, #12A, #16, ADA BATHROOM FIXTURE LEGEND. |
| U10 LINE OF CABINETS ABOVE. | U37 GRAB BAR IN PLACE FOR ALL FULLY ACCESSIBLE UNITS AT TRANSFER SHOWERS/TUBS. WALL REINFORCEMENT IS REQUIRED. REFER TO A6.13, #20, #21, ADA BATHROOM FIXTURE LEGEND. |
| U11 OPENING WIDTH TO MATCH INSTALLED VANITY DEPTH. | U38 LIGHT FIXTURE SCONCE. CENTER OVER COUNTERTOP. |
| U12 36" HIGH GRANITE COUNTER/ 34" MAX HIGH COUNTER AT FULLY ACCESSIBLE UNITS. 24" MAX DEEP COUNTERTOP AT FULLY ACCESSIBLE UNITS. | U39 CEILING FAN WITH LIGHT KIT ENERGY STAR- PROVIDE WALL CONTROL SWITCH. REFER TO ELECTRICAL DRAWINGS FOR DETAILS. BOTTOM OF FAN SHALL BE 7'-0" MIN. AFF. |
| U13 15" WIDTH X 24" DEPTH PANTRY WITH FALSE BACK AT 24" DEPTH. | U40 TRACK LIGHT FIXTURE. REFER TO ELECTRICAL PLANS. |
| U14 12" DEEP VINYL COATED ADJUSTABLE WIRE SHELF W/ HANGER ROD. | U41 OUTSIDE AIR INTAKE TO AC CLOSET. COORDINATE WITH MECHANICAL DRAWINGS. |
| U15 16" DEEP VINYL COATED WIRE SHELF MOUNTED AT 54" A.F.F. AT LEAST ONE AT 54" A.F.F. ALL LINENS HAVE (5) SHELVES. | U42 FLOOR AREA DRAIN FOR ROLL-IN SHOWERS. REFER TO PLUMBING. |
| U16 ELECTRICAL PANEL. REFER TO A6.13 FOR INSTALLATION GUIDELINES. ALSO REFER TO ELECTRICAL PLANS FOR DETAILS. | U43 N/A |
| U17 UNDERMOUNT LAVATORY / 6" DEEP MIN. REFER TO A-6.13, #4, BATHROOM FIXTURE LEGEND. | U44 BACKSPLASH STARTING AT COUNTERTOP AND ENDING AT BOTTOM OF UPPER CABINETS. |
| U18 FULLY ACCESSIBLE LAVATORY W/ ENCLOSURE. REFER TO A-6.13, #6 & #8A, ADA BATHROOM FIXTURE LEGEND. | U45 ROLL OUT DRAWER/SHELF W/ D-PULL TYPE HANDLES. |
| U19 TOILET. REFER TO A-6.13, #1, BATHROOM FIXTURE LEGEND. | U46 VERTICAL PANEL FROM FLOOR TO TOP OF OVERHEAD CABINET. FINISHED WITH PLASTIC LAMINATE ON VISIBLE SIDES. |
| U20 ROLL-IN SHOWER STALL SHALL HAVE AN IMPERVIOUS FINISH UP TO CEILING ABOVE DRAIN PER FBC 2020. REFER TO A-6.13, #14 BATHROOM FIXTURE LEGEND, ADA BATHROOM FIXTURE LEGEND #14, #15, #17, #18, #19. | U47 COORDINATE TOILET AND DRYER EXHAUST WITH MECHANICAL DRAWINGS. |
| U21 SHOWER STALL SHALL HAVE AN IMPERVIOUS FINISH UP TO CEILING ABOVE DRAIN PER FBC 2020. REFER TO A-6.13, #14, BATHROOM FIXTURE LEGEND. | U48 30" WIDE CLEAR COUNTER WORK SPACE. |
| U22 SLIP-RESISTANT TUB SHALL HAVE AN IMPERVIOUS FINISH UP TO CEILING ABOVE DRAIN PER FBC 2020. FINISHED DIMENSION AS PER TUB MANUFACTURER. REFER TO A-6.13, #11, BATHROOM FIXTURE LEGEND. | U49 CENTER LIGHT OVER VANITY. |
| U23 CONTROL AREA. REFER TO A-6.13, #12, BATHROOM FIXTURE LEGEND. DUAL CONTROL VALVE TO SELECT HANDLE OR FIXED SHOWER HEAD AT FULLY ACCESSIBLE UNITS. | U50 WALL MOUNTED SHOWER HEAD. WATER SENSE 2.0 GALLONS/MINUTE. REFER TO A6.16, BATHROOM FIXTURE LEGEND. |
| U24 WALL MOUNTED SHOWER HEAD. PROVIDE HANDLE WITH ADJUSTABLE BAR FOR ALL ROLL-IN SHOWER AND FULLY ACCESSIBLE UNITS. REFER TO A6.13, #5 ADA BATHROOM FIXTURE LEGEND. | |
| U25 34" HIGH GRANITE COUNTER. PROVIDE 4" HIGH BACKSPLASH TO MATCH COUNTERTOP MATERIAL ONLY AT BATHROOM/VANITY COUNTERS. | |
| U26 HIDDEN LINES DENOTES FUTURE RETRACTABLE GRAB BAR INSTALLATION. REFER TO A6.11, DTL #1. | |
| U27 VANITY CABINET. REFER TO A6.13, #5 AT BATHROOM FIXTURE LEGEND FULLY ACC. REFER TO A6.13 #6 & #8A ADA BATHROOM FIXTURE LEGEND. | |

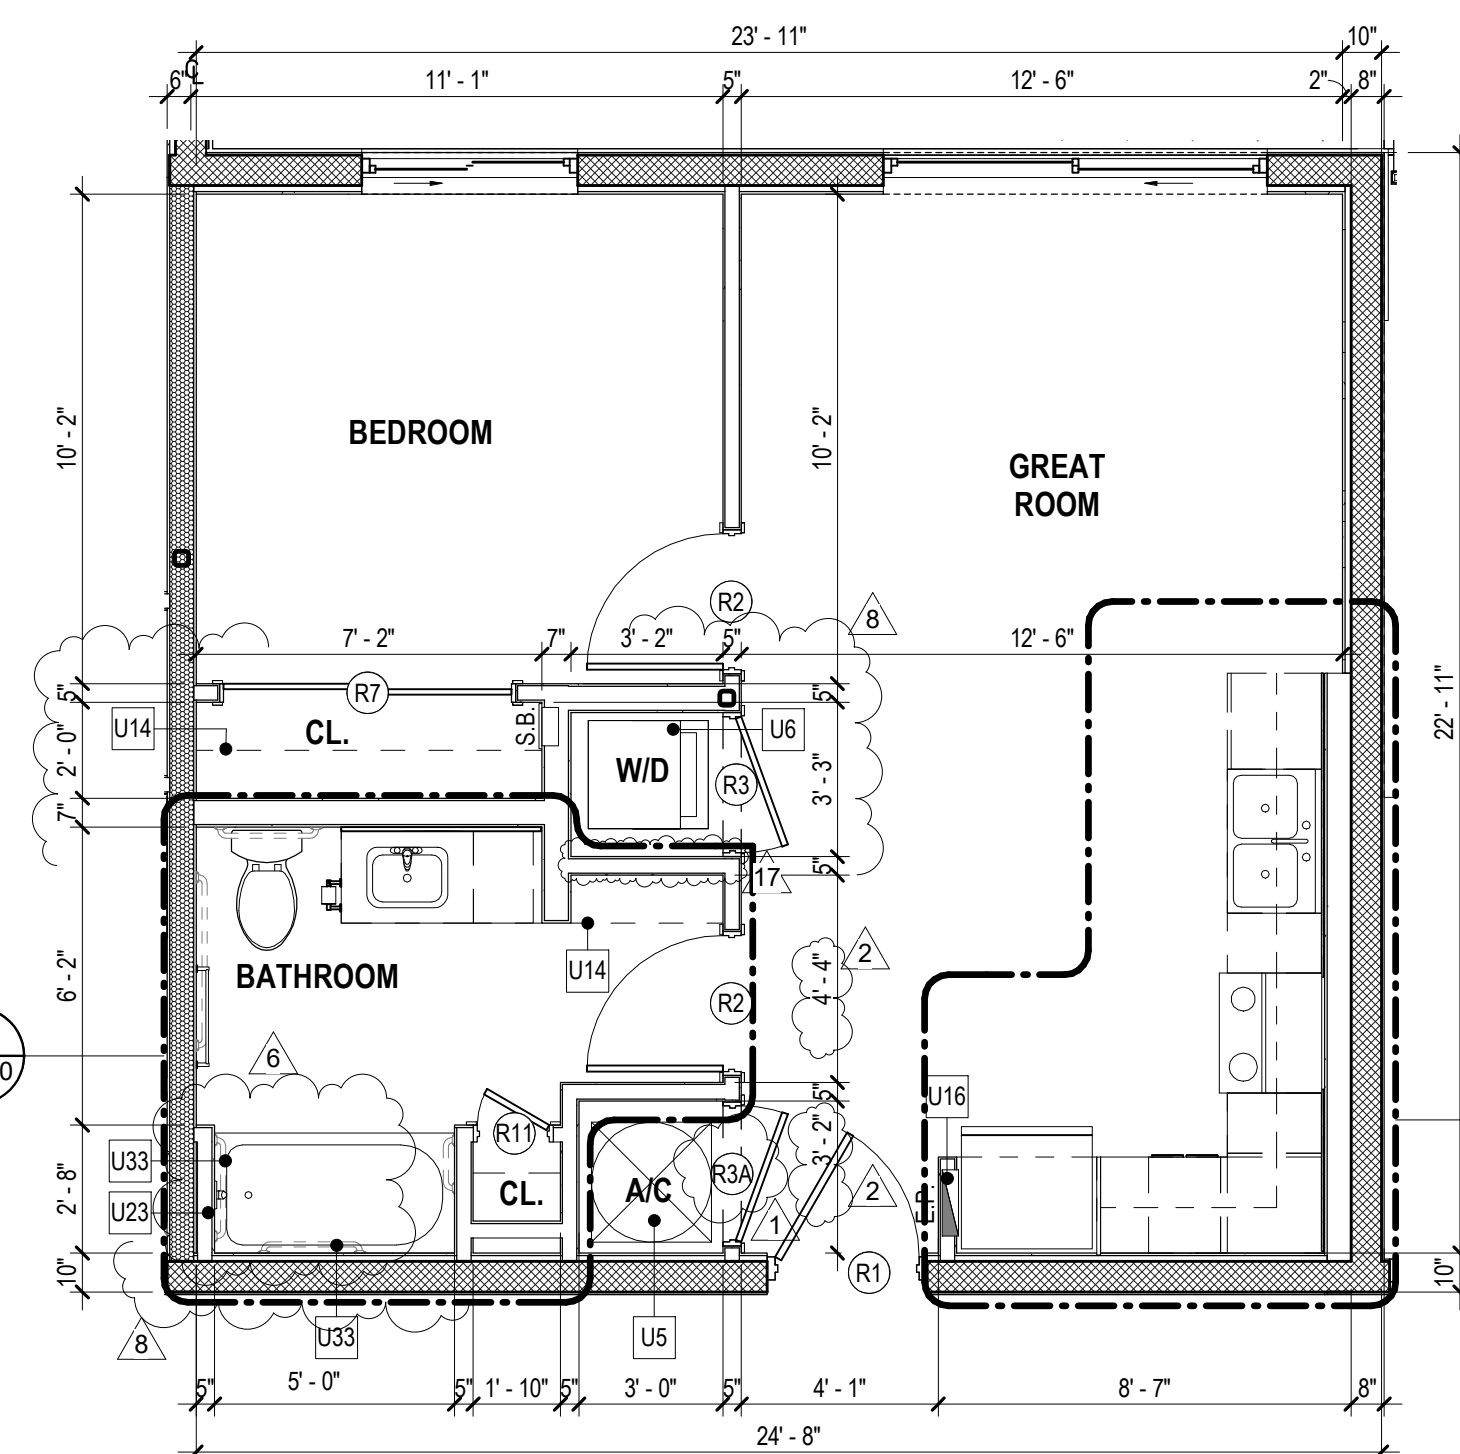

UNIT A-1 FLOOR PLAN

SCALE: 1/4" = 1'-0"


GROUND FLOOR UNITS MUST COMPLY WITH FHA GUIDELINES

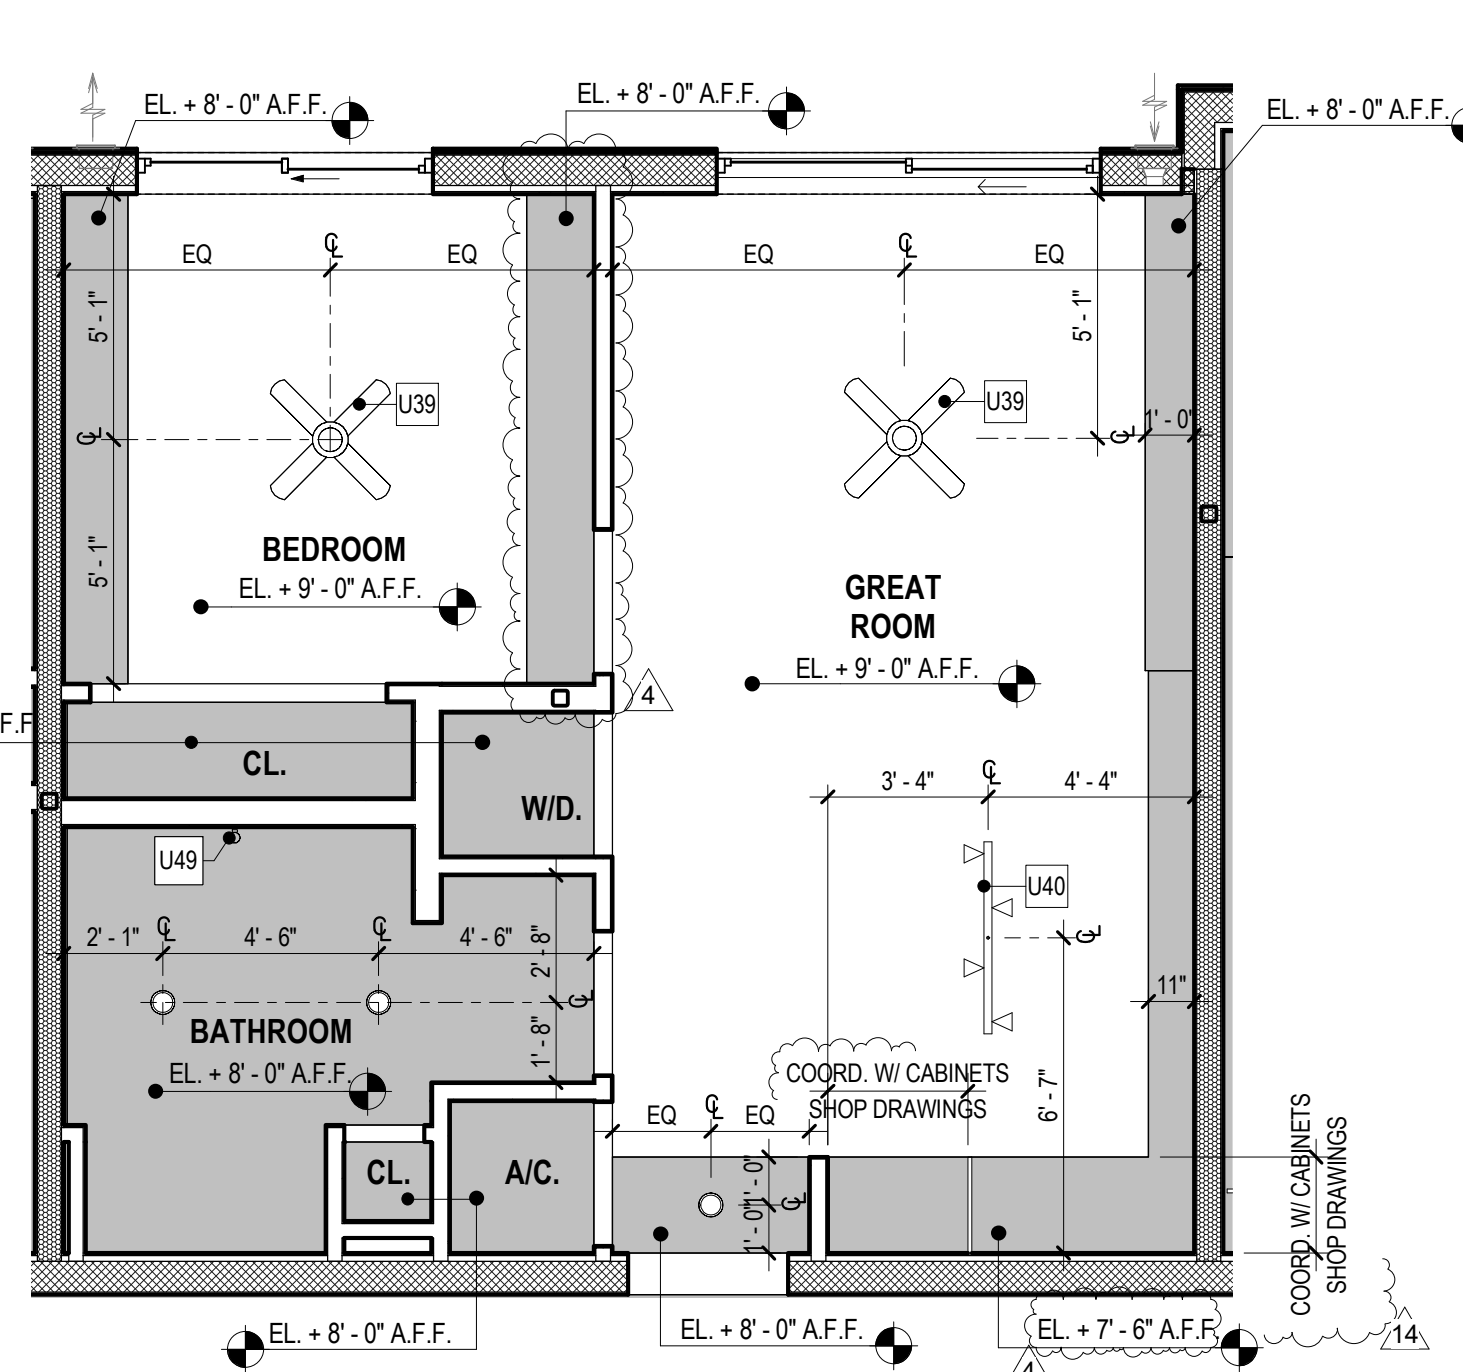

UNIT A-1 TYPICAL RCP

SCALE: 1/4" = 1'-0"


NOTE: AT 3RD LEVEL ONLY, PROVIDE 1HR FIRE RATED CEILING THROUGHOUT. CEILING IS TO BE INSTALLED ATTACHED DIRECTLY TO THE TRUSS BOTTOM CHORD. APPROX. A.F.F. ELEV. + 4'-5". SOFFITS WILL BE PROVIDED AT NOTED TO COORDINATE WITH KITCHEN CABINETS HEIGHT AND MEP PLANS LAYOUT.

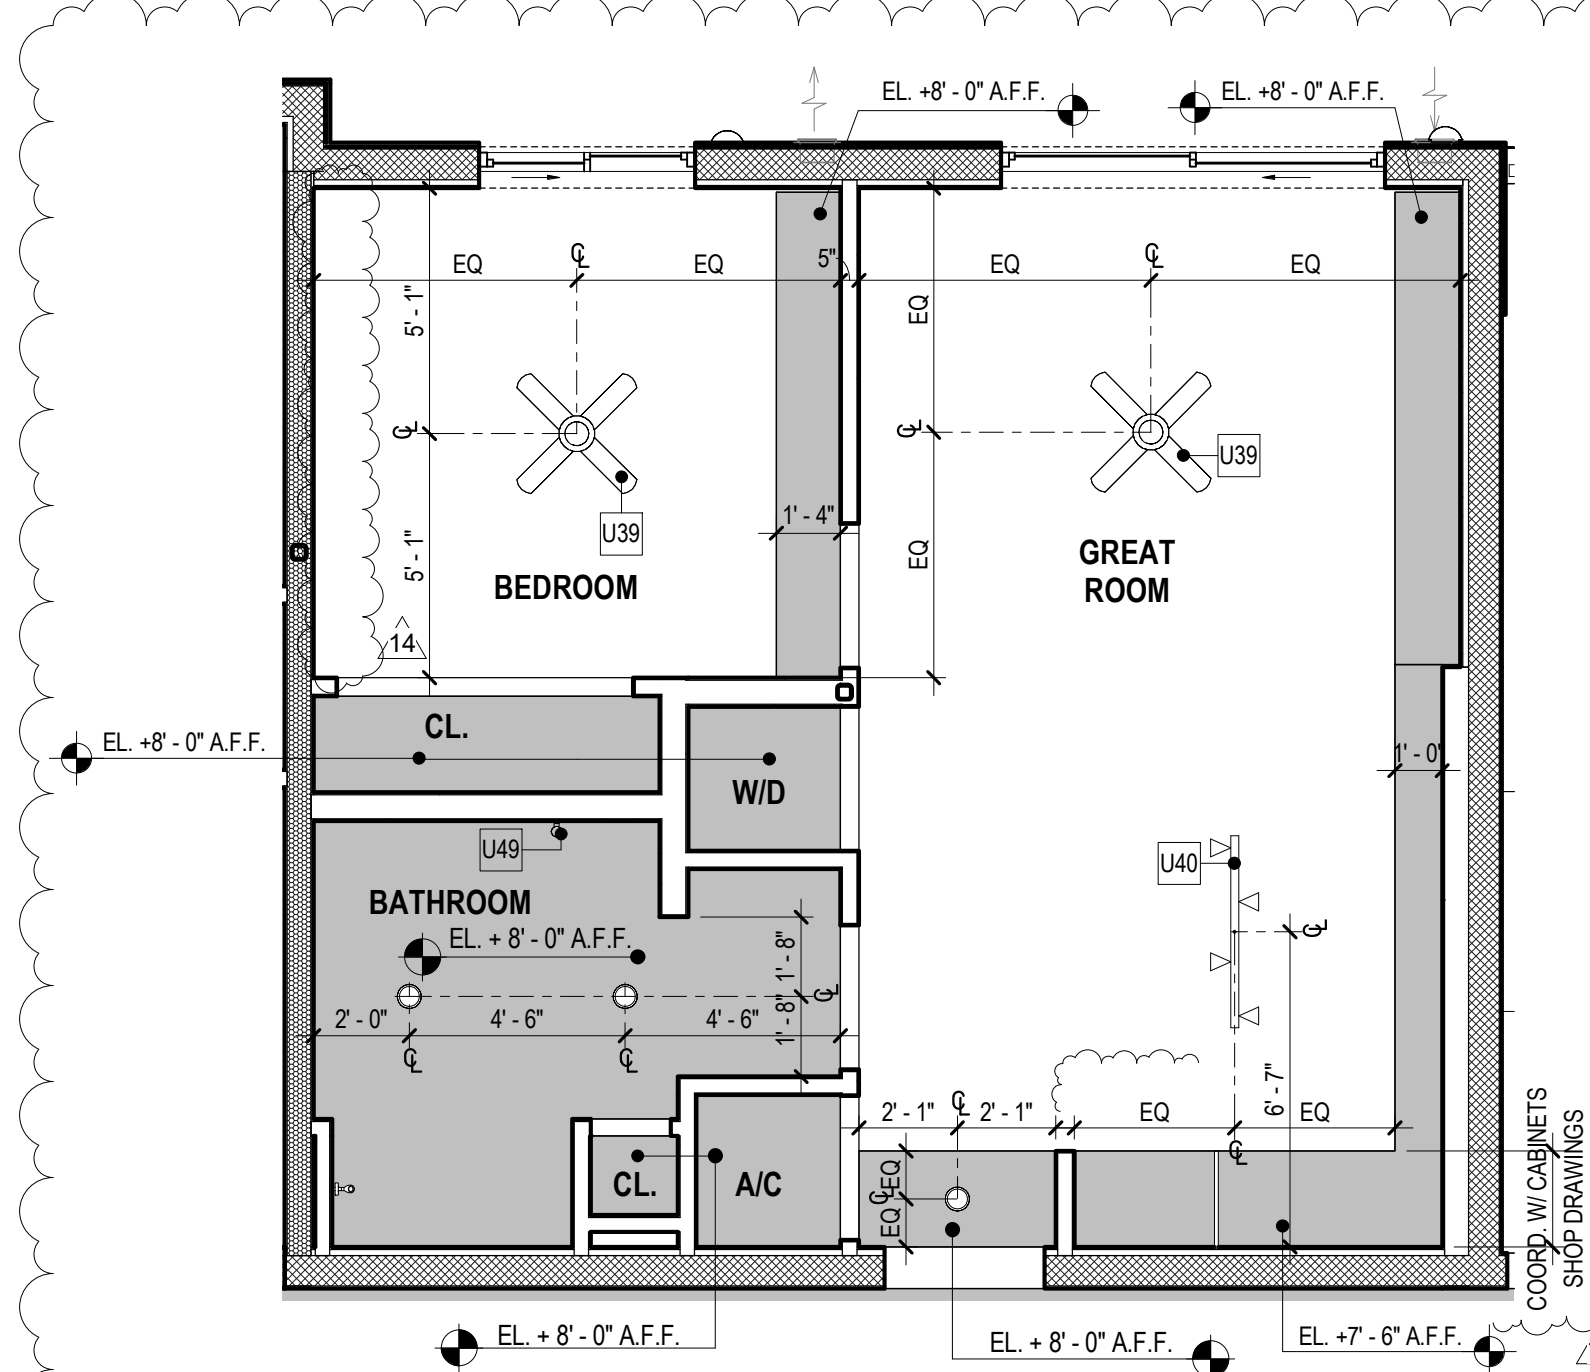

UNIT A-1 RCP

SCALE: 1/4" = 1'-0"




CONDITION BETWEEN GRID LINE 23 & 24 & STAIR #1, AND GRID LINE 23 & 24

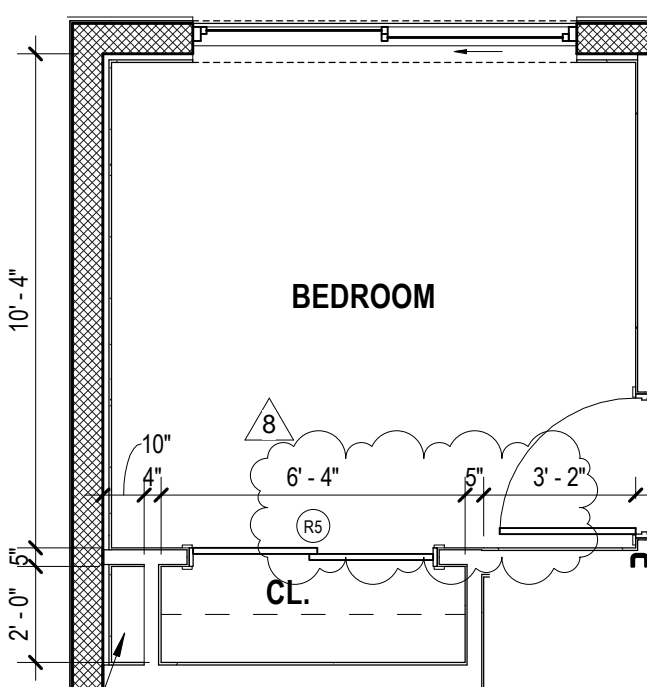

UNIT A-1 ALT FLOOR PLAN


SCALE: 1/4" = 1'-0"

ONLY @ GROUND FLOOR BLDG IN NORTH EAST SIDE

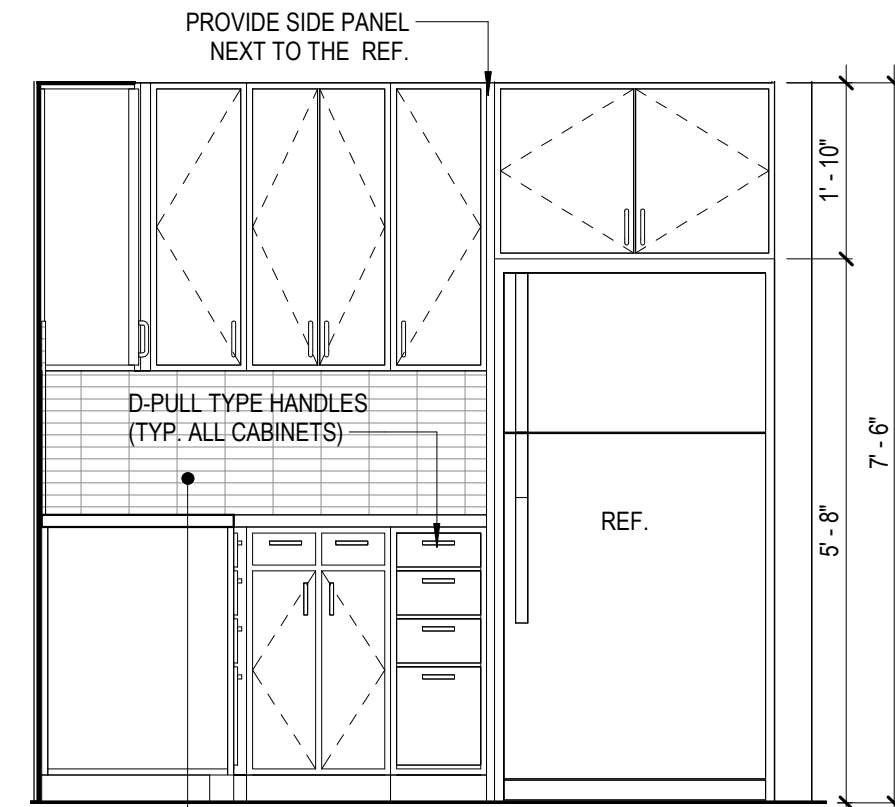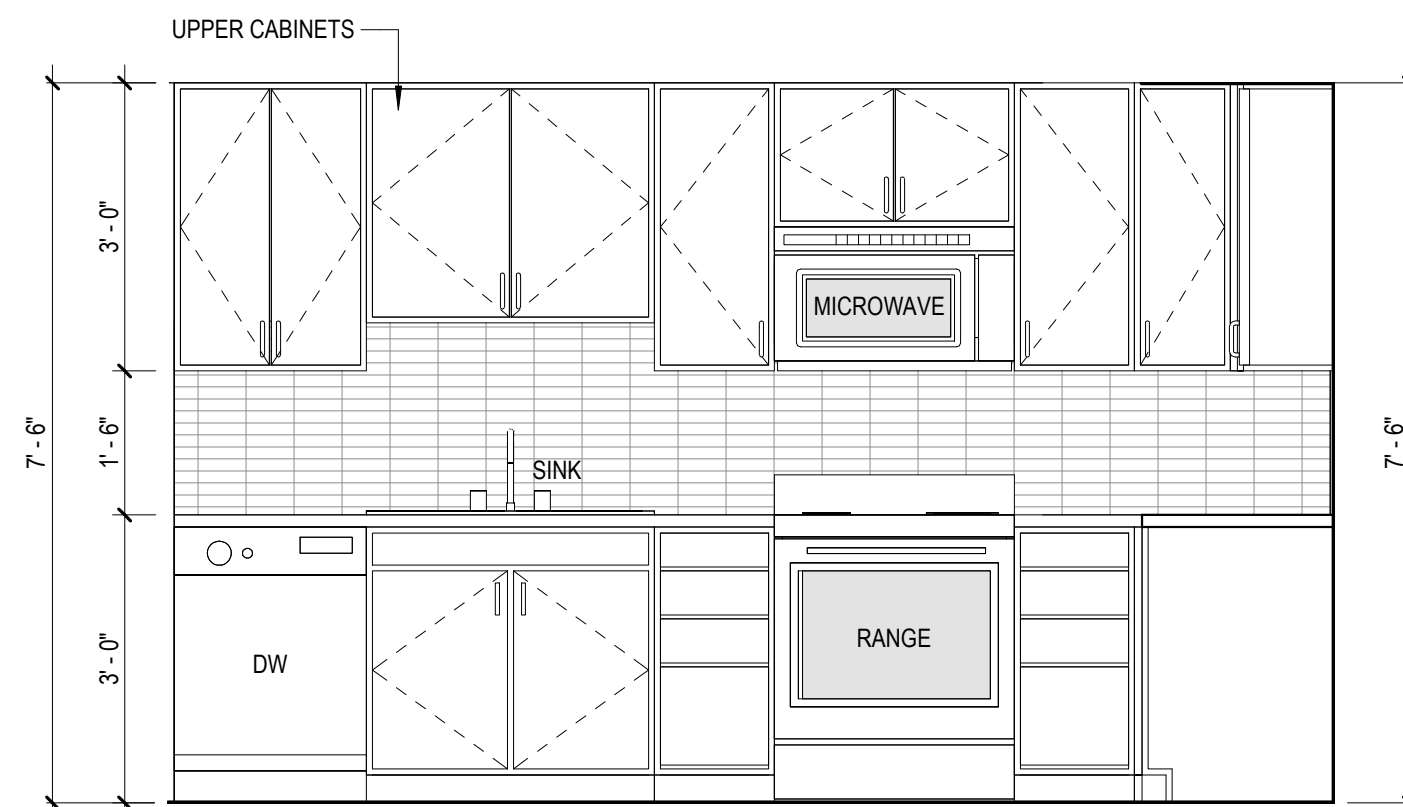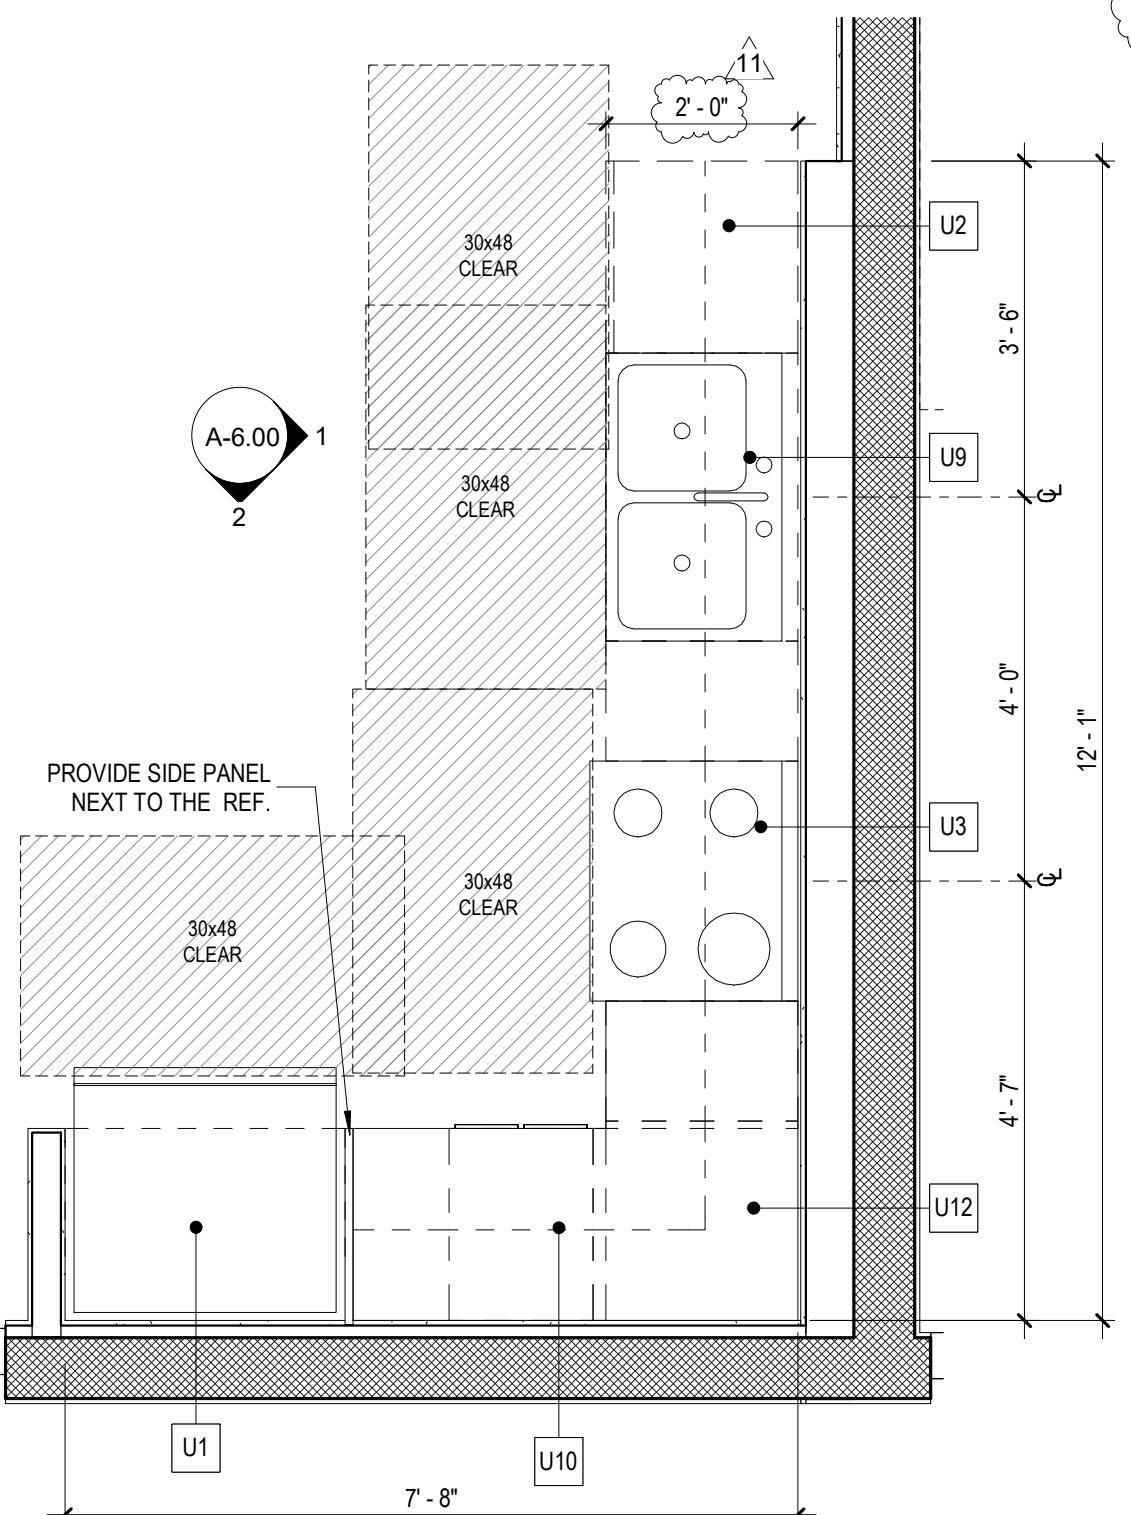

*UNIT A-1 - LIGHTING & VENTILATION CALCULATIONS					
ROOM NAME	ROOM AREA (SQ. FT)	GLAZING AREA PROVIDED (SQ. FT.)	VENT. AREA (SQ. FT.)	LIGHTING (8% MIN)	VENTILATION (4% MIN.)
GREAT ROOM (WS2)	241.16	53.86	18.23	22.33%	7.56%
BEDROOM (WS1)	111.57	25.02	13.8	22.43%	12.37%

* CURRENT TABLE SHOWS MOST STRINGENT WINDOW OPENING OPTION.
**VALUES TO BE VERIFIED FROM WINDOW MANUFACTURER'S SPECIFICATION.

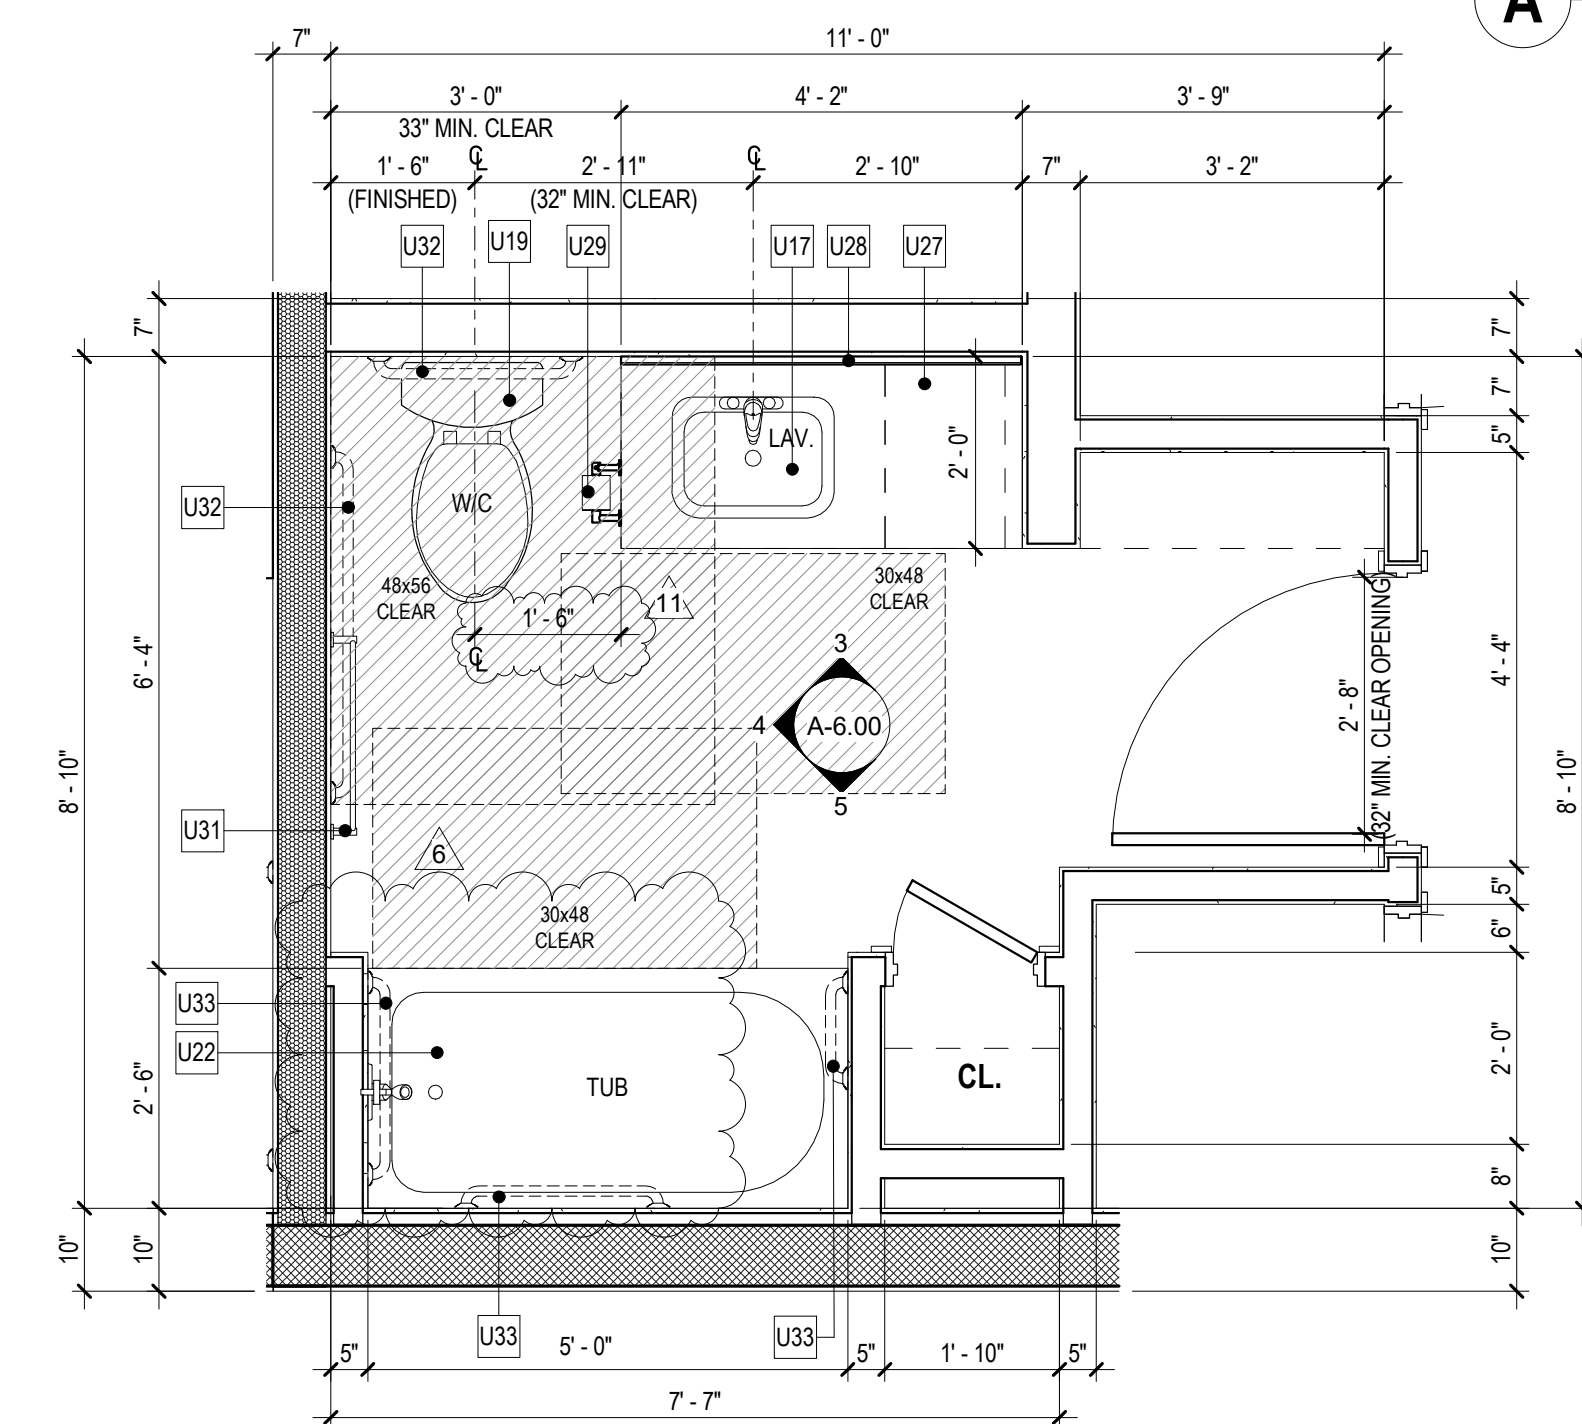

UNIT A-1 - BATHROOM

SCALE: 1/2" = 1'-0"


FHA TYPE "B"

UNIT A-1 - KITCHEN

SCALE: 1/2" = 1'-0"


UNIT A-1 KITCHEN ELEV.

SCALE: 1/2" = 1'-0"

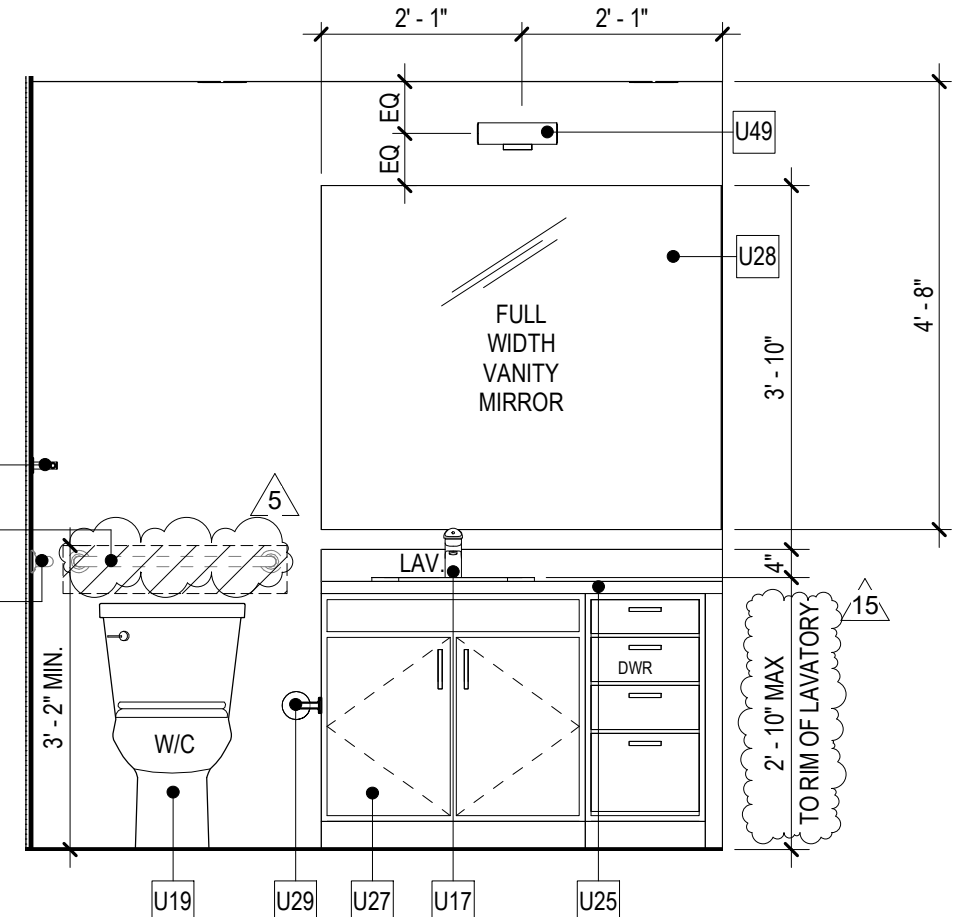


UNIT A-1 BATHROOM ELEV.

SCALE: 1/2" = 1'-0"

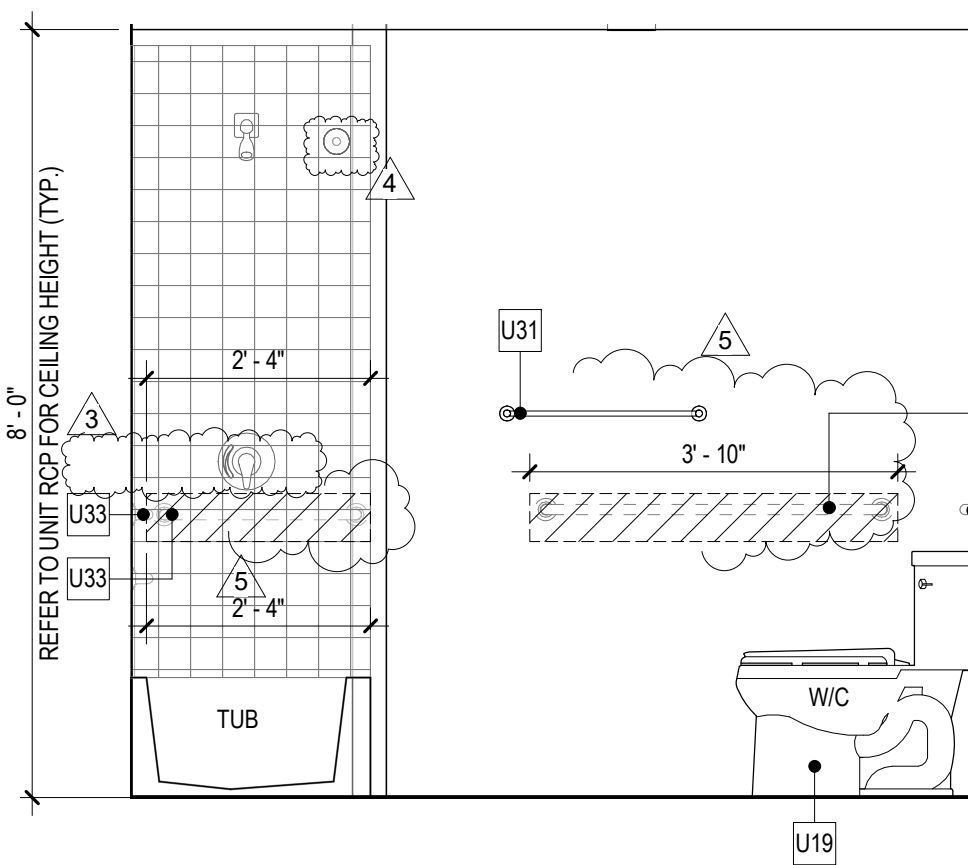

UNIT A-1 BATHROOM ELEV.

SCALE: 1/2" = 1'-0"

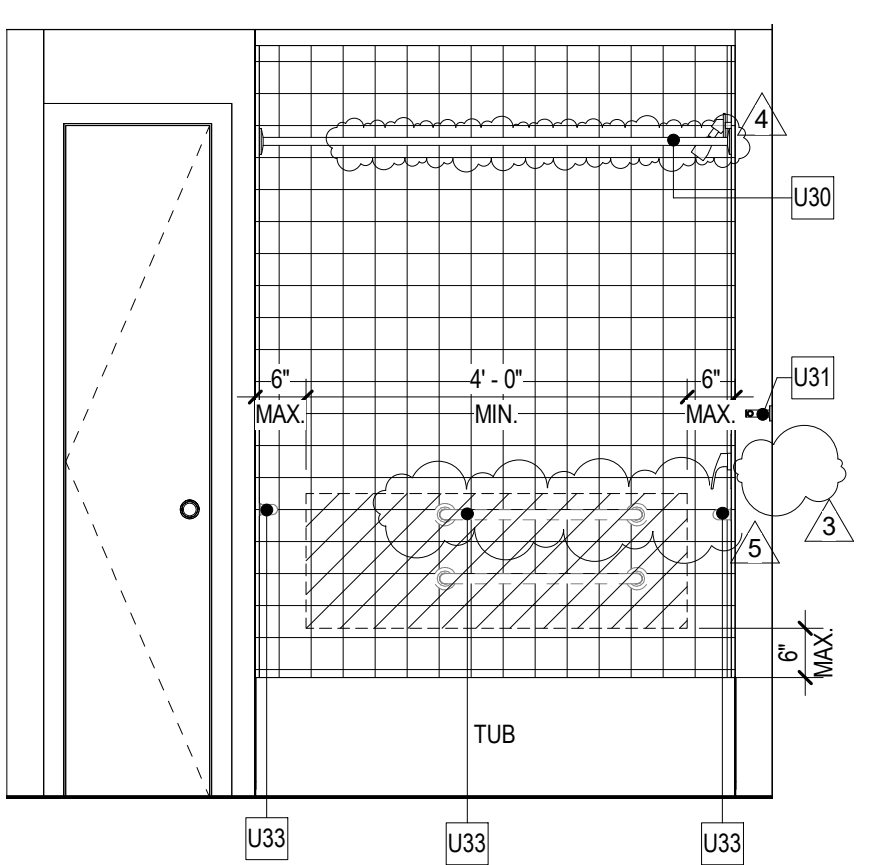

UNIT A-1 BATHROOM ELEV.

SCALE: 1/2" = 1'-0"