



ATLANTIC
PACIFIC
COMMUNITIES

 UNIT D-1a ACC. FLOOR PLANS & DETAILS
(CONTINUED)



REVISIONS		
No.	Revision Description	Date
3	Bldg. Dept. Com.	04/05/2
4	COORDINATION	04/26/2
5	Bldg. Dept. Com.	04/26/2
11	Bldg. Dept. Com.	08/13/2
15	ADA/FHA Revision	01/07/2

DATE: 12-21-2023
JOB No.: 2023-
DRAWN BY: YJ, MA, TA
APPR BY: AL
PRINTED: 5/16/2025 11:02:29

A-6.09A

UNIT PLAN - WALL & SYMBOL LEGEND

	REIN. CMU WALL (REFER TO STRUCT.)	(Z)	DENOTES QUANTITY
	REIN. CMU WALL (2 HOUR RATED) (REFER TO STRUCT.)	(RD)	DOOR NUMBER. REFER TO DOOR SCHEDULE
	REIN. SHEAR WALL (2 HR RATED)	(CL)	CENTER LINE
	8" LOW PARAPET WALL @ 42" MIN.	(WS)	WALL TYPE. SEE SHEET A-6.01
	TYP. METAL STUD PARTITION WALL	(J)	JUNCTION BOX (ELECT.) RECESS IN SLAB ABOVE / SCONCE ON WALL
	TYP. 1 HOUR TENANT SEPARATIONSMOKE BARRIER METAL STUD PARTITION WALL - REFER TO OVERALL FLOOR PLAN FOR WALL TYPE	(E.P.)	ELECTRICAL PANEL (COORDINATE WITH ELECTRICAL DRAWINGS)
	2 HOUR UL RATED SHUTT WALL	(WS1)	WINDOW SYSTEM. REFER TO WINDOW SCHEDULE
(A)	WINDOW TYPE. REFER TO WINDOW SCHEDULE		WALL REINFORCEMENT REQUIRED FOR FUTURE GRAB BAR INSTALLATION AT ALL OF UNITS (FHA COMPLIANTS)

UNIT NOTES

- UNLESS OTHERWISE INDICATED, INTERIOR PARTITIONS, SHOULD BE WALL TYPE: #29 & #31. REFER TO WALL TYPE SCHEDULE SHEET A-6.01.
- ALL W/DO CLOSET REAR WALLS SHALL BE W29, 6" METAL STUD MIN.
- TYPICAL DIMENSIONS ARE TO FINISHED SURFACES. DIMENSIONS TO STRUCTURAL ELEMENTS ARE TO FACE OF CORE. THICKNESS OF BATHROOM TILE FINISHES ARE NOT INCLUDED IN WALL ASSEMBLY AND THEREFORE NOT INCLUDED IN FINISHED DIMENSIONS.
- REFER TO OVERALL FLOOR PLAN FOR OVERALL DIMENSION OF UNITS. OVERALL DIMENSION OF UNITS MAY VARY, BUT NO MORE THAN 6" DISCREPANCIES SHALL BE NOTIFIED TO ARCHITECT.
- FLOOR SHALL MEET AN ICC OF 50 AND STIC OF 50
- DEMISING WALLS SHALL MEET A STIC OF 50
- FOR WINDOW TYPE AND LOCATION PLEASE REFER TO OVERALL FLOOR PLANS
- ALL DOORS INTO ROOMS AND CLOSETS SHALL HAVE A CLEAR PASSAGE WIDTH OF 32" MIN.
- INSTALLATION OF HIGH SPEED INTERNET SHALL BE PROVIDED.
- NOTE: SEE SHEET [A-6.08](#) FOR BATHROOM FUTURE LEGEND
- FOR UNIT TYPE LIGHTING AND VENTILATION CALCULATIONS, SEE SHEET [A-6.01](#) - A-6.11.
- PROVIDE LATICRETE HYDRO BAN DRAIN BEARING WATERPROOFING MEMBRANE (OR APPROVED EQUAL) UNDER FLOORING/TILES AT ALL SHOWER WALLS AND THROUGHOUT THE ENTIRE BATHROOM FLOOR AREA.
- REFER TO A-8.08 FOR UNIT DOOR SCHEDULE, FINISH SCHEDULE AND FIXTURES SCHEDULE

CEILING NOTES

- COORDINATE ALL CEILING FIXTURES SHOWN ON REFLECTED CEILING PLAN WITH ELECTRICAL DRAWINGS. ALL FIXTURES IN FIRST FLOOR SLAB SHALL BE ONE HOUR FIRE RATED OR HAVE A FIRE RATED JUNCTION BOX INSTALLED TO MAINTAIN 1 HOUR SLAB RATING.
- TYPICAL DIMENSIONS ARE TO FINISHED SURFACES. DIMENSIONS TO STRUCTURAL ELEMENTS ARE TO FACE OF CORE. THICKNESS OF BATHROOM TILE FINISHES ARE NOT INCLUDED IN WALL ASSEMBLY AND THEREFORE NOT INCLUDED IN FINISHED DIMENSIONS.
- ALL ELEVATIONS SHOWN ON PLAN TO BE ABOVE FINISH FLOOR SLAB (TYP. U.O.C.).
- FOR FIXTURE TYPE AND SPECIFICATIONS, SEE ELECTRICAL DRAWINGS. SUBMIT ALL SHOP DRAWINGS FOR APPROVAL PRIOR TO PROCUREMENT.
- FIXTURES SHALL NOT BE SPACED LESS THAN 4" FROM OTHER FIXTURES & SHALL BE EQUALLY SPACED WITHIN A ROOM OR SPACE, UNLESS OTHERWISE SHOWN -COORDINATE WITH FIRE ALARM DRAWINGS.
- COORDINATE WITH MECHANICAL AND FIRE PROTECTION DRAWINGS FOR LOCATION OF DUCT, DIFFUSER & SPRINKLER.
- ALL FIXTURES SHALL BE NEW & INSTALLED AS PER MANUFACTURERS RECOMMENDATION.
- MINIMUM OF 7'-10" SHALL BE THE TYP. CEILING HEIGHT UNLESS OTHERWISE NOTED.
- ALL AUDIOVISUAL EMERGENCY EQUIPMENT SHALL BE AS PER OWNERS REQUIREMENTS AND GUIDELINES. CONTRACTOR SHALL REFER TO ELECTRICAL DRAWINGS AND CONSULT OWNER DURING AND AFTER SD0 PROCESS.
- VERIFY ALL SOFFIT SPACE AS REQ'D FOR RUNNING DUCTS.
- ALLOWANCE FOR ADDITIONAL SOFFITS SHALL BE PROVIDED FOR FIELD CONTINGENCY CONDITIONS.

CEILING LEGEND

	GYPSUM BOARD	(J)	JUNCTION BOX		URFACE PANEL LIGHT FIXTURE
	CEILING FAN - B.O. FAN SHALL BE 7" MIN. CLR. A.F.F.		6" RECESSED H-HAT LIGHT FIXTURE		WALL MOUNTED LIGHT FIXTURE


NOTES:

WINDOW TREATMENT:
PROVIDE WINDOW TREATMENT BY HUNTER DOUGLAS OR APPROVED EQUAL. WINDOW TREATMENTS SHALL COMPLY WITH WDMA A 100.1 AND NFPA 701. PRODUCT SHALL BE MANUFACTURED FREE OF TOXIC OR HAZARDOUS MATERIALS. OPERABLE PARTS SHALL COMPLY WITH ADA REQUIREMENTS AND BE INSTALLED AT 48" MAX AFF.


DIMENSIONS:
A. DIMENSIONS ARE TO FINISHED SURFACES UNLESS OTHERWISE NOTED.
B. THICKNESS OF TILE NOT INCLUDED IN WALL ASSEMBLY AND THEREFORE NOT INCLUDED IN FINISHED DIMENSIONS.

UNIT KEYNOTE LEGEND


	U1 ENERGY STAR REFRIGERATOR (PROVIDE CONNECTION FOR ICE MAKER).		U28 MIRROR TO MATCH WIDTH OF VANITY. HEIGHT TO BE COORDINATED WITH LIGHT FIXTURE. REFER TO A-6.13, #7/FHAADA BATHROOM FIXTURE LEGEND.
	U2 24" WIDE DISHWASHER (ENERGY STAR) ADA COMPLIANT @ ACCESSIBLE UNITS.		U29 TOILET PAPER HOLDER. REFER TO A-6.13 #8/FHAADA BATHROOM FIXTURE LEGEND.
	U3 FULL SIZE RANGE WITH OVEN AND MICROWAVE ABOVE/ FULLY AC. RANGE WITH HOOD FAN ABOVE AT FULLY ACCESSIBLE UNITS.		U30 CURTAIN ROD. REFER TO FHA BATHROOM FIXTURE LEGEND A-6.13 DTL #13.
	U4 COUNTER TOP MICROWAVE ONLY @ ACCESSIBLE UNITS.		U31 TOWEL BAR. REFER TO FHAADA BATHROOM FIXTURE LEGEND A-6.13 DTL #9.
	U5 ENERGY STAR ELECTRICAL WATER HEATER / A.H.U. PROVIDE MIN. 4" CLEARANCE AROUND A.H.U PER FBC 2020 (MECH).		U32 HIDDEN LINE DENOTES FUTURE GRAB BAR INSTALLATION AT TOILET. WALL REINFORCEMENT IS REQUIRED. REFER TO FHA BATHROOM FIXTURE LEGEND A-6.13 DTL #2, #3.
	U6 FULL SIZE STACKABLE WASHER/DRYER (ENERGY STAR QUALIFIED) TYP. CONNECTIONS AS PER ELECTRICAL & PLUMBING.		U33 HIDDEN LINE DENOTES FUTURE GRAB BAR INSTALLATION AT TUB. WALL REINFORCEMENT IS REQUIRED. REFER TO FHA BATHROOM FIXTURE LEGEND A-6.13 DTL #3A, #3B, 3C.
	U7 FULL SIZE FRONT LOADING WASHER (ENERGY STAR). CONNECTIONS AS PER ELECTRICAL & PLUMBING.		U34 HIDDEN LINE DENOTES FUTURE GRAB BAR INSTALLATION AT TUB. WALL REINFORCEMENT IS REQUIRED. REFER TO FHA BATHROOM FIXTURE LEGEND A-6.13 DTL #12, #21, #22A.
	U8 FULL SIZE FRONT LOADING DRYER (ENERGY STAR). CONNECTIONS AS PER ELECTRICAL & PLUMBING.		U35 GRAB BAR IN PLACE FOR ALL FULLY ACCESSIBLE UNITS AT TOILET. WALL REINFORCEMENT IS REQUIRED. REFER TO A-6.13, #2, #3, ADA BATHROOM FIXTURE LEGEND.
	U9 UNDER MOUNTED DOUBLE KITCHEN SINK W/ GABAGE DISPOSAL (9" DEEP MIN. 6.5" DEEP MAX @ FULLY ACCESSIBLE UNITS).		U36 GRAB BAR IN PLACE FOR ALL FULLY ACCESSIBLE UNITS AT ROLL-IN SHOWERS/ CURB SHOWER. WALL REINFORCEMENT IS REQUIRED. REFER TO A-6.13, #12A, #16, ADA BATHROOM FIXTURE LEGEND.
	U10 LINE OF CABINETS ABOVE.		U37 GRAB BAR IN PLACE FOR ALL FULLY ACCESSIBLE UNITS AT TRANSFER SHOWERS/ TUBS. WALL REINFORCEMENT IS REQUIRED. REFER TO A-6.13, #20, #21, ADA BATHROOM FIXTURE LEGEND.
	U11 LINEN CABINET W/ DEPTH TO MATCH INSTALLED VANITY DEPTH.		U38 LIGHT FIXTURE SCONCE

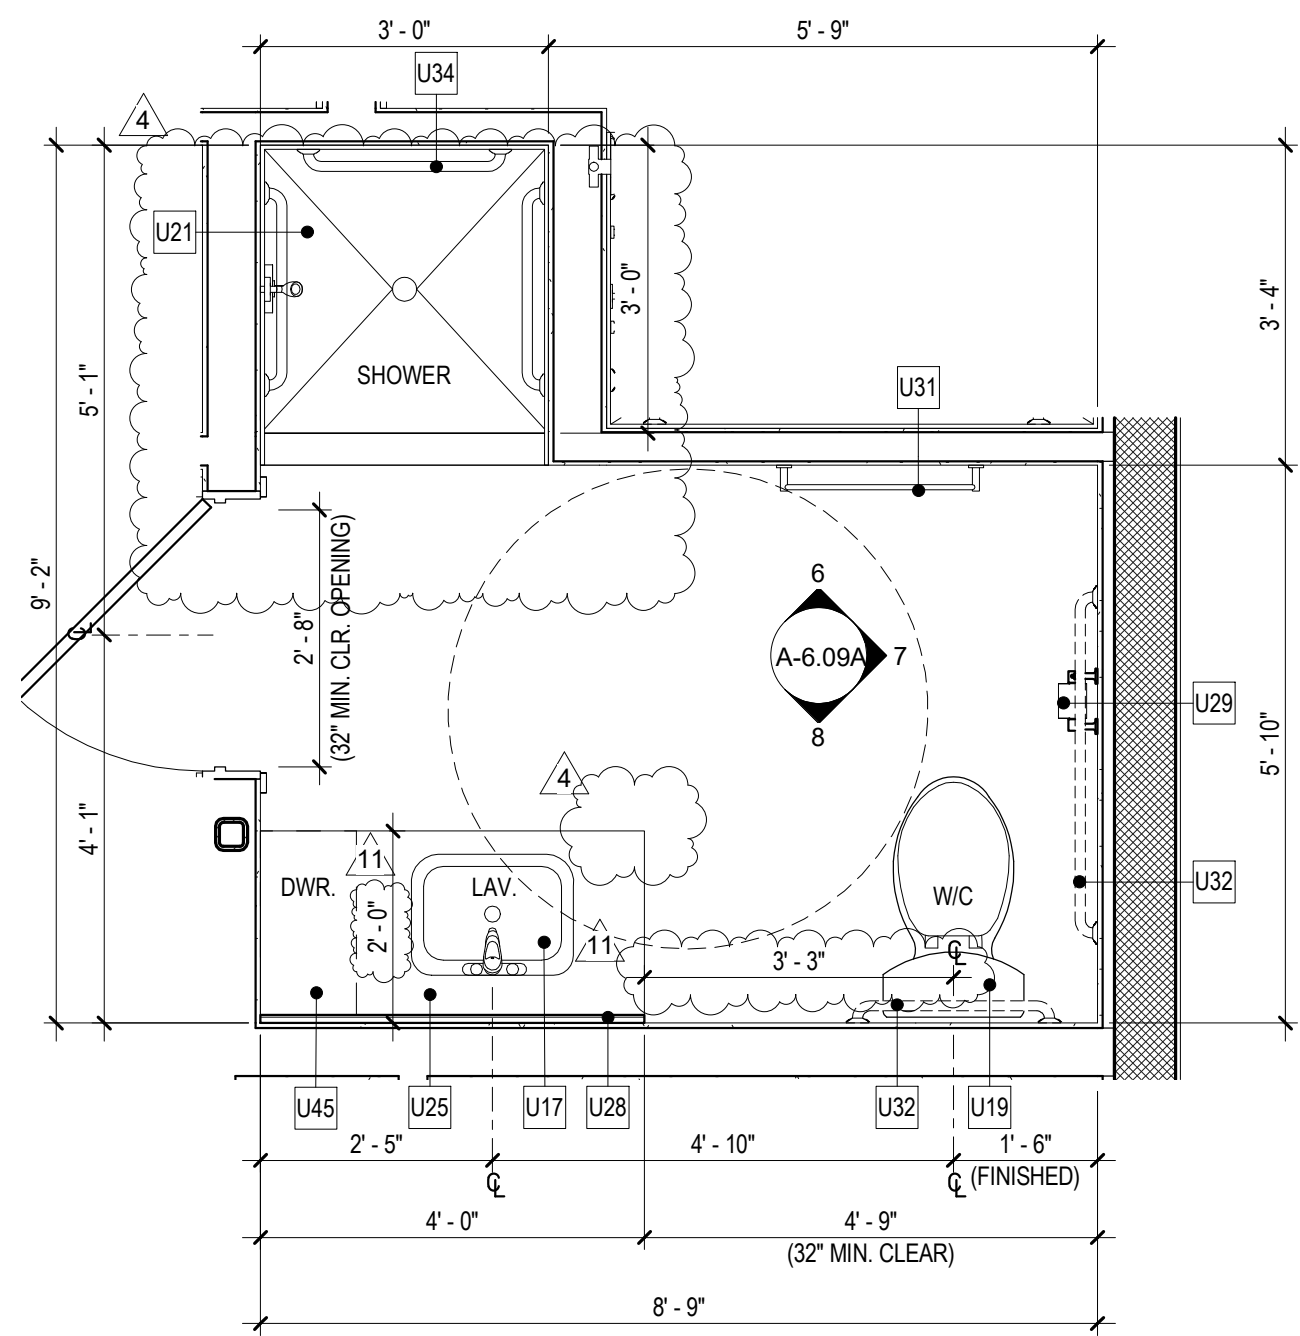


UNIT D-1a ACC. BATHROOM
SCALE: 1/2" = 1'-0"

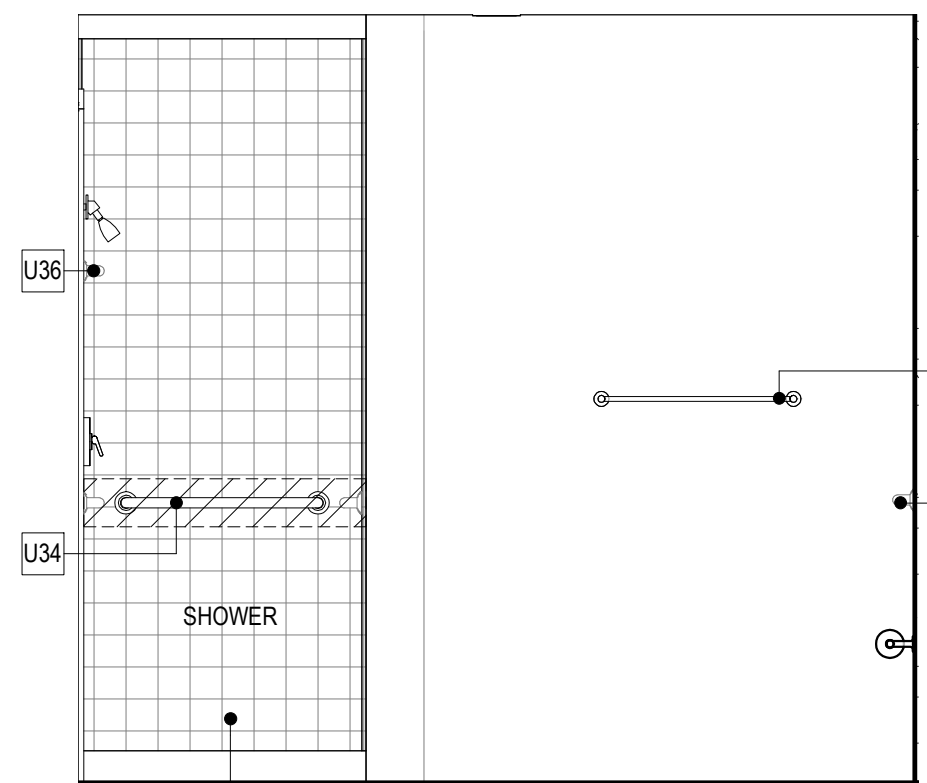


6 UNIT D-1a ACC. BATHROOM ELEV.
SCALE: 1/2" = 1'-0"

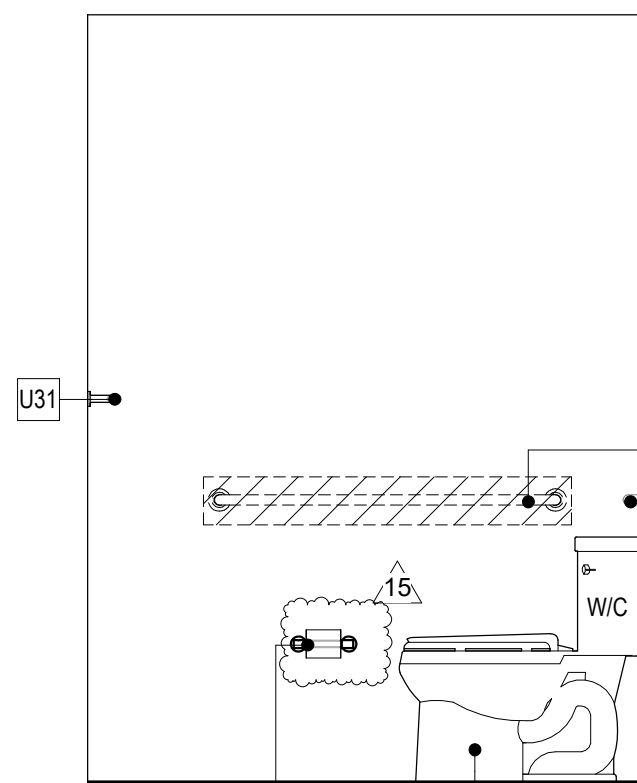


7 UNIT D-1a ACC. BATHROOM ELEV.
SCALE: 1/2" = 1'-0"

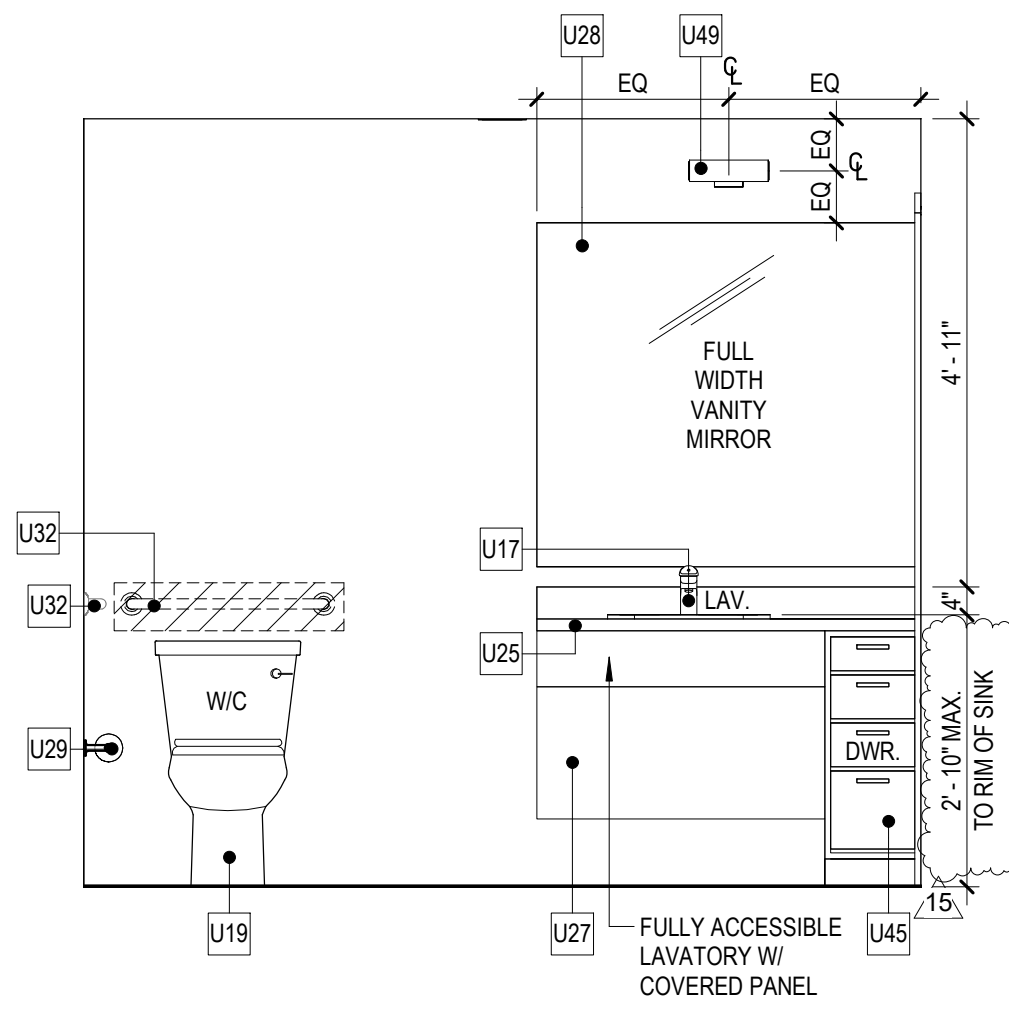


8 **UNIT D-1a ACC. BATHROOM ELEV.**
SCALE: 1/2" = 1'-0"

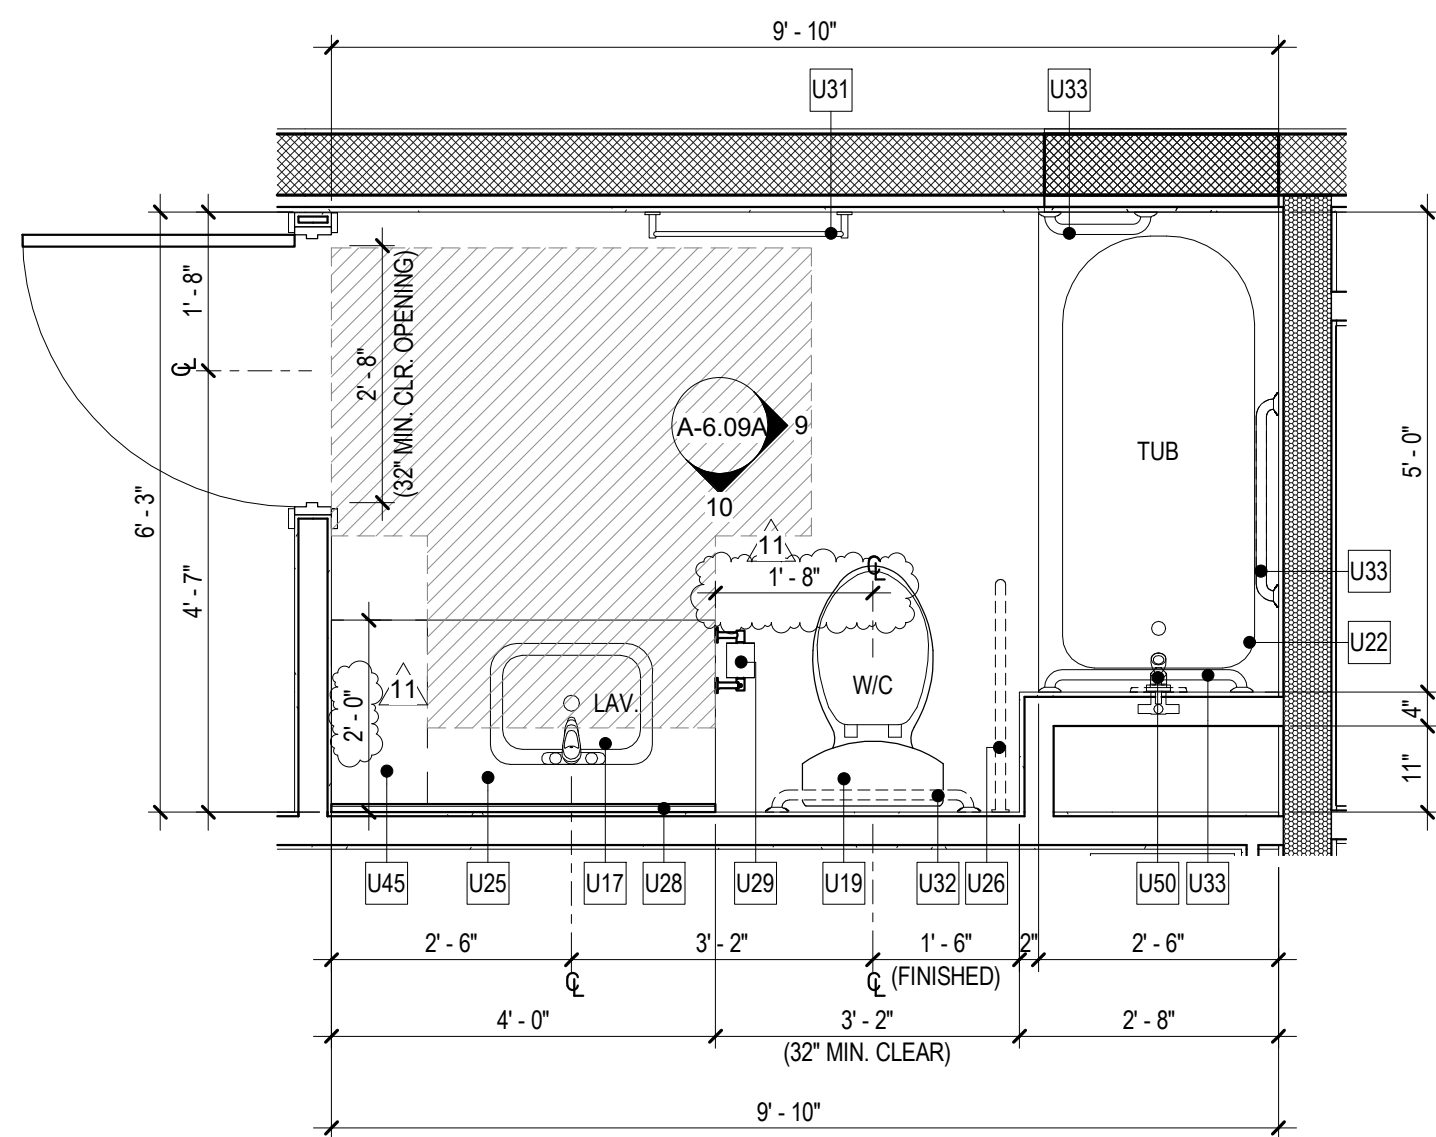

D UNIT D-1a ACC. BATHROOM
SCALE: 1/2" = 1'-0"

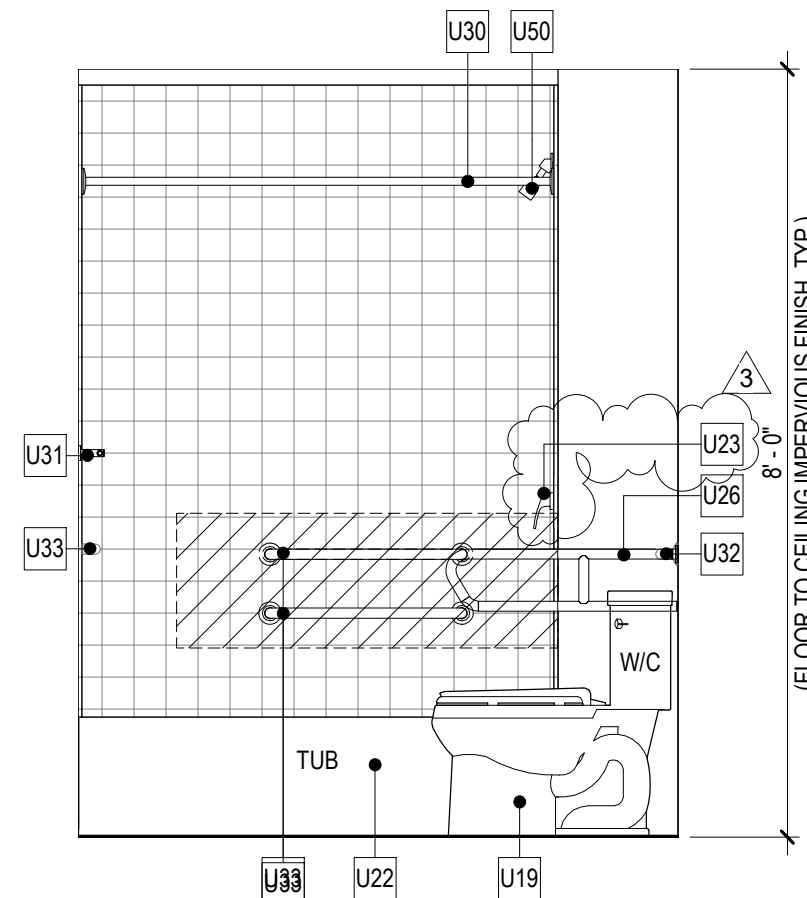

9 UNIT D-1a ACC. BATHROM ELEV.
SCALE: 1/2" = 1'-0"

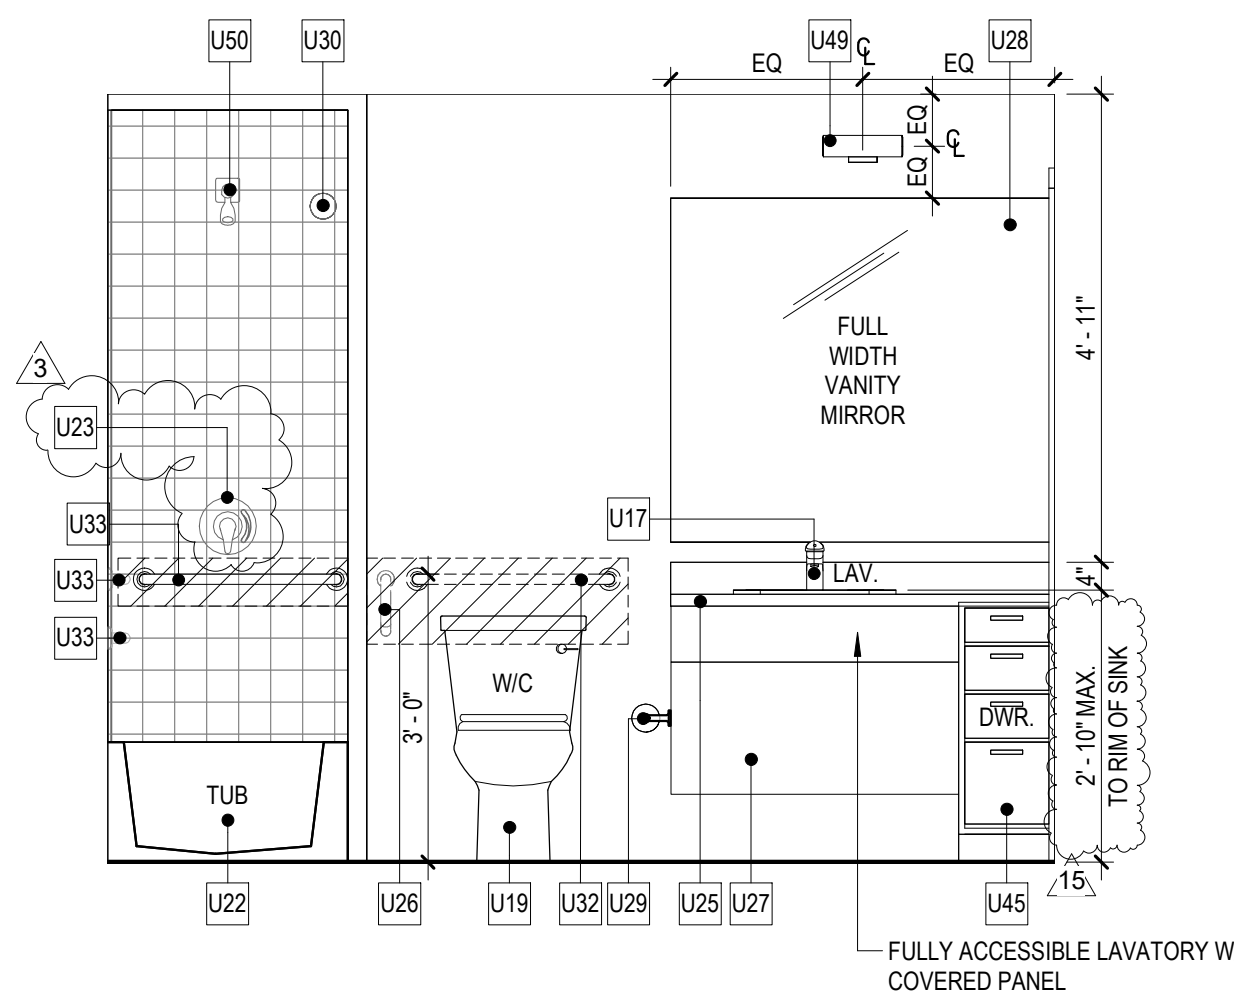

10 **UNIT D-1a ACC. BATHROOM ELEV.**
SCALE: 1/2" = 1'-0"

RFI 13

RFI 13

ATLANTIC
PACIFIC
— COMMUNITY BUILDERS —
Heritage Village South
Bulletin 2
DATE RECEIVED
05/15/2025